SCHEDULE OF WINDOWS

READ (VISUAL) FROM THIS SCHEDULE
- DW 01: NO. 1 read - plans 2 - OPEN
- DW 02: NO. 1 read - plans 0 - OPEN
- DW 03: NO. 152 read - plans 152 - CLOSED
- DW 04: NO. 10 read - plans 10 - CLOSED
- DW 05: NO. 5 read - plans 5 - CLOSED
- DW 06: NO. 4 read - plans 4 - CLOSED
- DW 07: NO. 1 read - plans 1 - CLOSED
- DW 08: NO. 8 read - plans 8 - CLOSED
- DW 09: NO. 4 read - plans 4 - CLOSED
- DW 10: NO. 1 read - plans 1 - CLOSED
- DW 12: NO. 1 read - plans 1 - CLOSED


DW 01

TYPE	PARTLY FIXED PARTLY SLIDING DOOR
SIZE	AS SHOWN
LOCATION	MAIN ENTRANCE
NO.	01

DESCRIPTION:

POWDER COATED ALUMINUM FRAMED DOOR WINDOW (THERMAL BREAK) WITH 6MM REFLECTIVE BELGIUM HEAT STRENGTHENED GLASS+12MM AIR GAP+ 6MM TEMPERED CLEAR GLASS.
GLASS PERFORMANCE (U VALUE& SHADING COEFFICIENT) SHALL BE AS PER GREEN BUILDING REQUIREMENTS.

* SHALL BE PROVIDED WITH WEATHER STRIPS

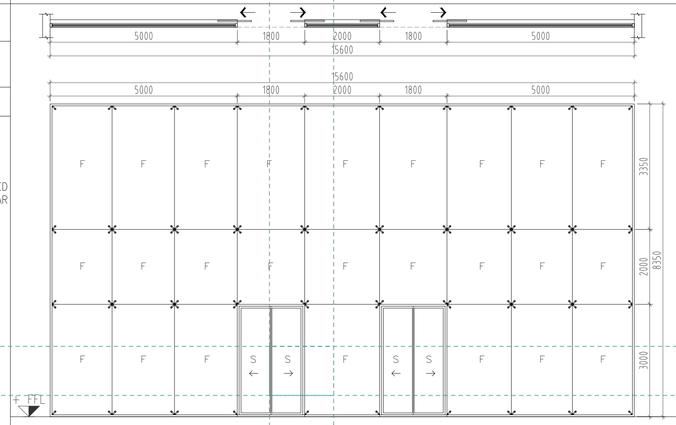


DW 02

TYPE	PARTLY FIXED PARTLY SLIDING DOOR
SIZE	AS SHOWN
LOCATION	LIFT LOBBY (BASEMENT FLOOR)
NO.	01

DESCRIPTION:

POWDER COATED ALUMINUM FRAMED DOOR WINDOW (THERMAL BREAK) WITH 6MM REFLECTIVE BELGIUM HEAT STRENGTHENED GLASS+12MM AIR GAP+ 6MM TEMPERED CLEAR GLASS.
GLASS PERFORMANCE (U VALUE& SHADING COEFFICIENT) SHALL BE AS PER GREEN BUILDING REQUIREMENTS.

* SHALL BE PROVIDED WITH WEATHER STRIPS

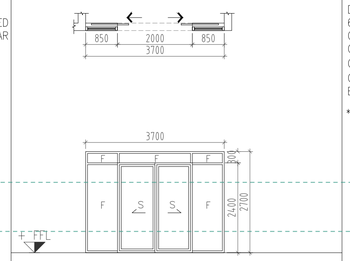


DW 03

TYPE	PARTLY FIXED PARTLY SLIDING DOOR
SIZE	AS SHOWN
LOCATION	DINING / LIVING (1ST TO 5TH FLOOR)
NO.	152

DESCRIPTION:

POWDER COATED ALUMINUM FRAMED DOOR WINDOW (THERMAL BREAK) WITH 6MM REFLECTIVE BELGIUM HEAT STRENGTHENED GLASS+12MM AIR GAP+ 6MM TEMPERED CLEAR GLASS.
GLASS PERFORMANCE (U VALUE& SHADING COEFFICIENT) SHALL BE AS PER GREEN BUILDING REQUIREMENTS.

* SHALL BE PROVIDED WITH WEATHER STRIPS

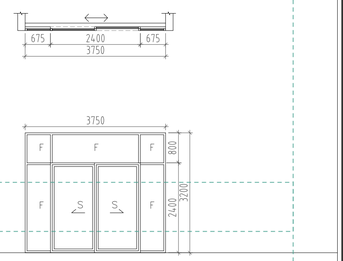


DW 04

TYPE	PARTLY FIXED PARTLY SLIDING DOOR
SIZE	AS SHOWN
LOCATION	DINING / LIVING,BEDRM (1ST TO 5TH FLOOR)
NO.	10

DESCRIPTION:

POWDER COATED ALUMINUM FRAMED DOOR WINDOW (THERMAL BREAK) WITH 6MM REFLECTIVE BELGIUM HEAT STRENGTHENED GLASS+12MM AIR GAP+ 6MM TEMPERED CLEAR GLASS.
GLASS PERFORMANCE (U VALUE& SHADING COEFFICIENT) SHALL BE AS PER GREEN BUILDING REQUIREMENTS.

* SHALL BE PROVIDED WITH WEATHER STRIPS

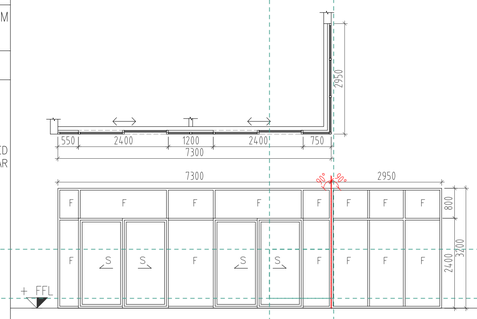


DW 05

TYPE	PARTLY FIXED PARTLY SLIDING DOOR
SIZE	AS SHOWN
LOCATION	DINING / LIVING (1ST TO 5TH FLOOR)
NO.	05

DESCRIPTION:

POWDER COATED ALUMINUM FRAMED DOOR WINDOW (THERMAL BREAK) WITH 6MM REFLECTIVE BELGIUM HEAT STRENGTHENED GLASS+12MM AIR GAP+ 6MM TEMPERED CLEAR GLASS.
GLASS PERFORMANCE (U VALUE& SHADING COEFFICIENT) SHALL BE AS PER GREEN BUILDING REQUIREMENTS.

* SHALL BE PROVIDED WITH WEATHER STRIPS

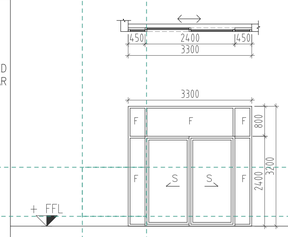


DW 06

TYPE	PARTLY FIXED PARTLY SLIDING DOOR
SIZE	AS SHOWN
LOCATION	DINING / LIVING,BEDRM (2ND TO 5TH FLOOR)
NO.	04

DESCRIPTION:

POWDER COATED ALUMINUM FRAMED DOOR WINDOW (THERMAL BREAK) WITH 6MM REFLECTIVE BELGIUM HEAT STRENGTHENED GLASS+12MM AIR GAP+ 6MM TEMPERED CLEAR GLASS.
GLASS PERFORMANCE (U VALUE& SHADING COEFFICIENT) SHALL BE AS PER GREEN BUILDING REQUIREMENTS.

* SHALL BE PROVIDED WITH WEATHER STRIPS

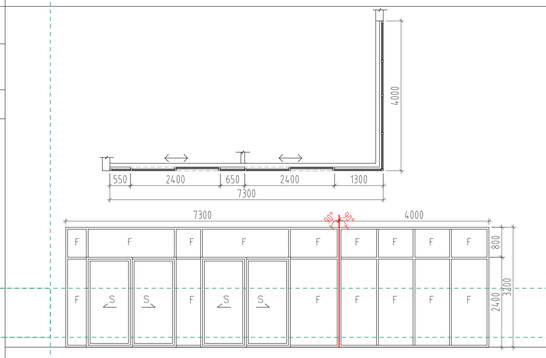


DW 07

TYPE	PARTLY FIXED PARTLY SLIDING DOOR
SIZE	AS SHOWN
LOCATION	DINING / LIVING,BEDRM (1ST FLOOR)
NO.	01

DESCRIPTION:

POWDER COATED ALUMINUM FRAMED DOOR WINDOW (THERMAL BREAK) WITH 6MM REFLECTIVE BELGIUM HEAT STRENGTHENED GLASS+12MM AIR GAP+ 6MM TEMPERED CLEAR GLASS.
GLASS PERFORMANCE (U VALUE& SHADING COEFFICIENT) SHALL BE AS PER GREEN BUILDING REQUIREMENTS.

* SHALL BE PROVIDED WITH WEATHER STRIPS

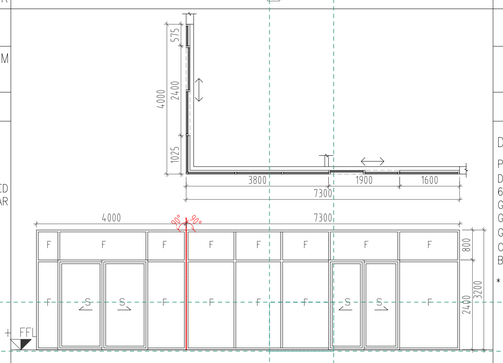


DW 08

TYPE	PARTLY FIXED PARTLY SLIDING DOOR
SIZE	AS SHOWN
LOCATION	DINING / LIVING (2ND TO 5TH FLOOR)
NO.	08

DESCRIPTION:

POWDER COATED ALUMINUM FRAMED DOOR WINDOW (THERMAL BREAK) WITH 6MM REFLECTIVE BELGIUM HEAT STRENGTHENED GLASS+12MM AIR GAP+ 6MM TEMPERED CLEAR GLASS.
GLASS PERFORMANCE (U VALUE& SHADING COEFFICIENT) SHALL BE AS PER GREEN BUILDING REQUIREMENTS.

* SHALL BE PROVIDED WITH WEATHER STRIPS

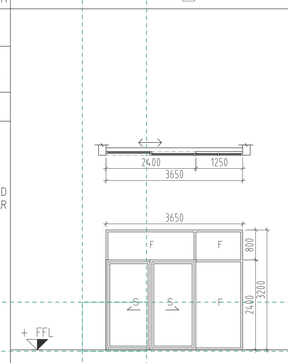


DW 09

TYPE	PARTLY FIXED PARTLY SLIDING DOOR
SIZE	AS SHOWN
LOCATION	DINING / LIVING,BEDRM (2ND TO 5TH FLOOR)
NO.	04

DESCRIPTION:

POWDER COATED ALUMINUM FRAMED DOOR WINDOW (THERMAL BREAK) WITH 6MM REFLECTIVE BELGIUM HEAT STRENGTHENED GLASS+12MM AIR GAP+ 6MM TEMPERED CLEAR GLASS.
GLASS PERFORMANCE (U VALUE& SHADING COEFFICIENT) SHALL BE AS PER GREEN BUILDING REQUIREMENTS.

* SHALL BE PROVIDED WITH WEATHER STRIPS

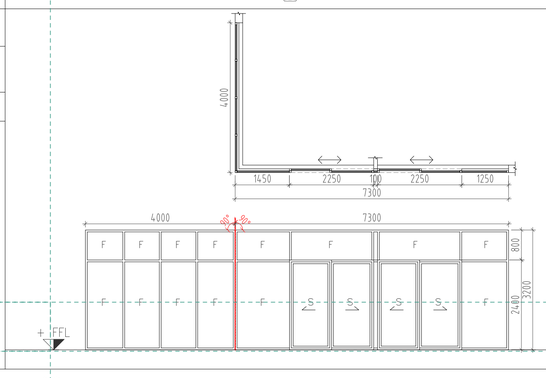


DW 10

TYPE	PARTLY FIXED PARTLY SLIDING DOOR
SIZE	AS SHOWN
LOCATION	GYMNASIUM (M) (LOWER ROOF)
NO.	01

DESCRIPTION:

POWDER COATED ALUMINUM FRAMED DOOR WINDOW (THERMAL BREAK) WITH 6MM REFLECTIVE BELGIUM HEAT STRENGTHENED GLASS+12MM AIR GAP+ 6MM TEMPERED CLEAR GLASS.
GLASS PERFORMANCE (U VALUE& SHADING COEFFICIENT) SHALL BE AS PER GREEN BUILDING REQUIREMENTS.

* SHALL BE PROVIDED WITH WEATHER STRIPS

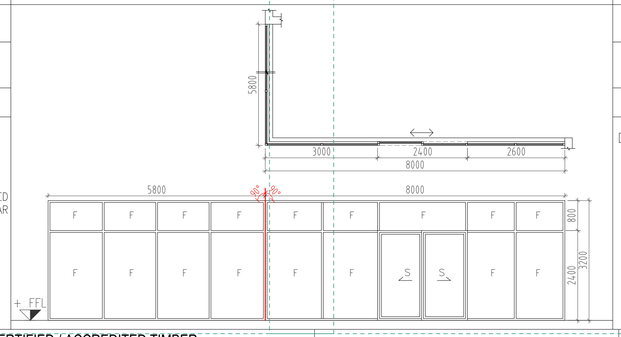


DW 12

TYPE	PARTLY FIXED PARTLY SLIDING DOOR
SIZE	AS SHOWN
LOCATION	GYMNASIUM (F) (LOWER ROOF)
NO.	01

DESCRIPTION:

POWDER COATED ALUMINUM FRAMED DOOR WINDOW (THERMAL BREAK) WITH 6MM REFLECTIVE BELGIUM HEAT STRENGTHENED GLASS+12MM AIR GAP+ 6MM TEMPERED CLEAR GLASS.
GLASS PERFORMANCE (U VALUE& SHADING COEFFICIENT) SHALL BE AS PER GREEN BUILDING REQUIREMENTS.

* SHALL BE PROVIDED WITH WEATHER STRIPS

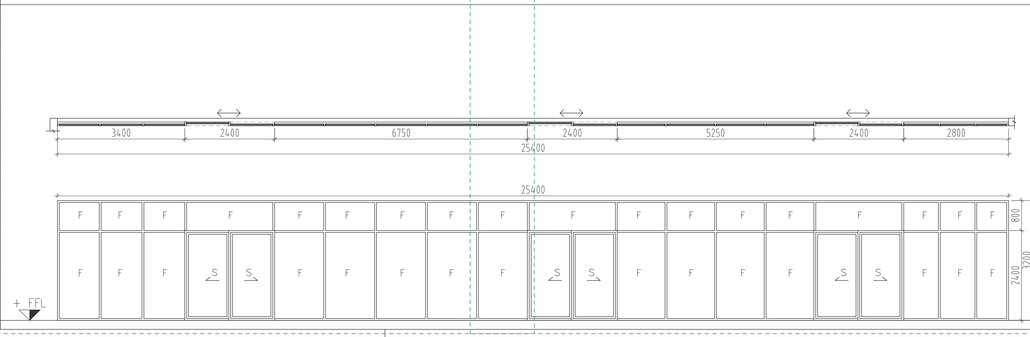

NOTE.: ALL TIMBER/WOOD TO BE CERTIFIED / ACCREDITED TIMBER AS PER CLAUSE 701.02/701.06/701.07/701.08/404.01 GBR SP-2

PROVIDE EXTERNAL THRESHOLD FOR TERRACES

*U VALUE = 1.7 w/m2K
ALL APPARTMENT BALCONY DOORS WINDOWS AND MAIN DOORS LEADING TO CORRIDORS HAS TO BE WETHER STRIPPED.

*SHADING COEFFICIENT = 0.20
* COLOUR & DESIGN AS PER CONSULTANTS APPROVAL

NOTES:

1. THIS DRAWING MAY NOT BE REPRODUCED BY ANY MEANS WITHOUT PRIOR APPROVAL FROM EMSQUARE
2. DRAWINGS ARE NOT TO BE SCALED, STATED DIMENSIONS ONLY ARE TO BE TAKEN.
3. ANY INCONSISTENCY OR DISCRIPANCY IS TO BE BROUGHT TO THE ATTENTION OF & RESOLVED BY THE ARCHITECT/ENGINEER BEFORE THE WORK IS PUT IN HAND.

DATE	DESCRIPTION	BY

CONSULTANT :

EMSQUARE
ENGINEERING CONSULTANTS
ARCHITECTS-CIVIL ENGINEERS-INTERIORS
P.O. Box 181903, Tel: +971 4 2729009, Fax: +971 4 2729334
Email: emsquare@emirates.net.ae

OWNER :

G F S REAL ESTATE L.L.C

JOB TITLE :

PROPOSED RESIDENTIAL BUILDING (B+G+5+ROOF)

PLOT NO. / PARCEL ID	BLOCK / COMMUNITY
5310319	SAIH SHUAIB 2

DRAWING TITLE :

SCHEDULE OF WINDOWS-01

ARCHITECT :	STRUCTURAL ENGR. :	DRAWN :
SMITHA		SHAFI
SCALE :	DATE :	CHECKED BY :
1:125	JUN-2025	BABU
JOB NO :	DRAWING NO. :	REVISION NO. :
—	A-13-002	..

: D:\ANJU PROJECTS 2023\PROJECTS\GFS\08. 5310319 - COVENTRY RESIDENCE 3 - G F S REAL ESTATE L.L.C\FINAL SUBMISSION\FINAL AUTHORITY SUB\ARCH\CAD\A-13-002 SCHEDULE OF WINDOWS.dwg