
A-07-009 UPPER ROOF PLAN - take-off markup. 23 grid bays matched by label to dimensions stated on other sheets, spread 0.19%; effective scale 1:152.4 (title block 1:150)

TAKE-OFF ON THIS SHEET (trade colours)
H-H D-1: 1 tag(s) here - count OPEN
H-Y DW 11: 3 tag(s) here - count CLOSED
H-Z DW 12: 1 tag(s) here - count CLOSED

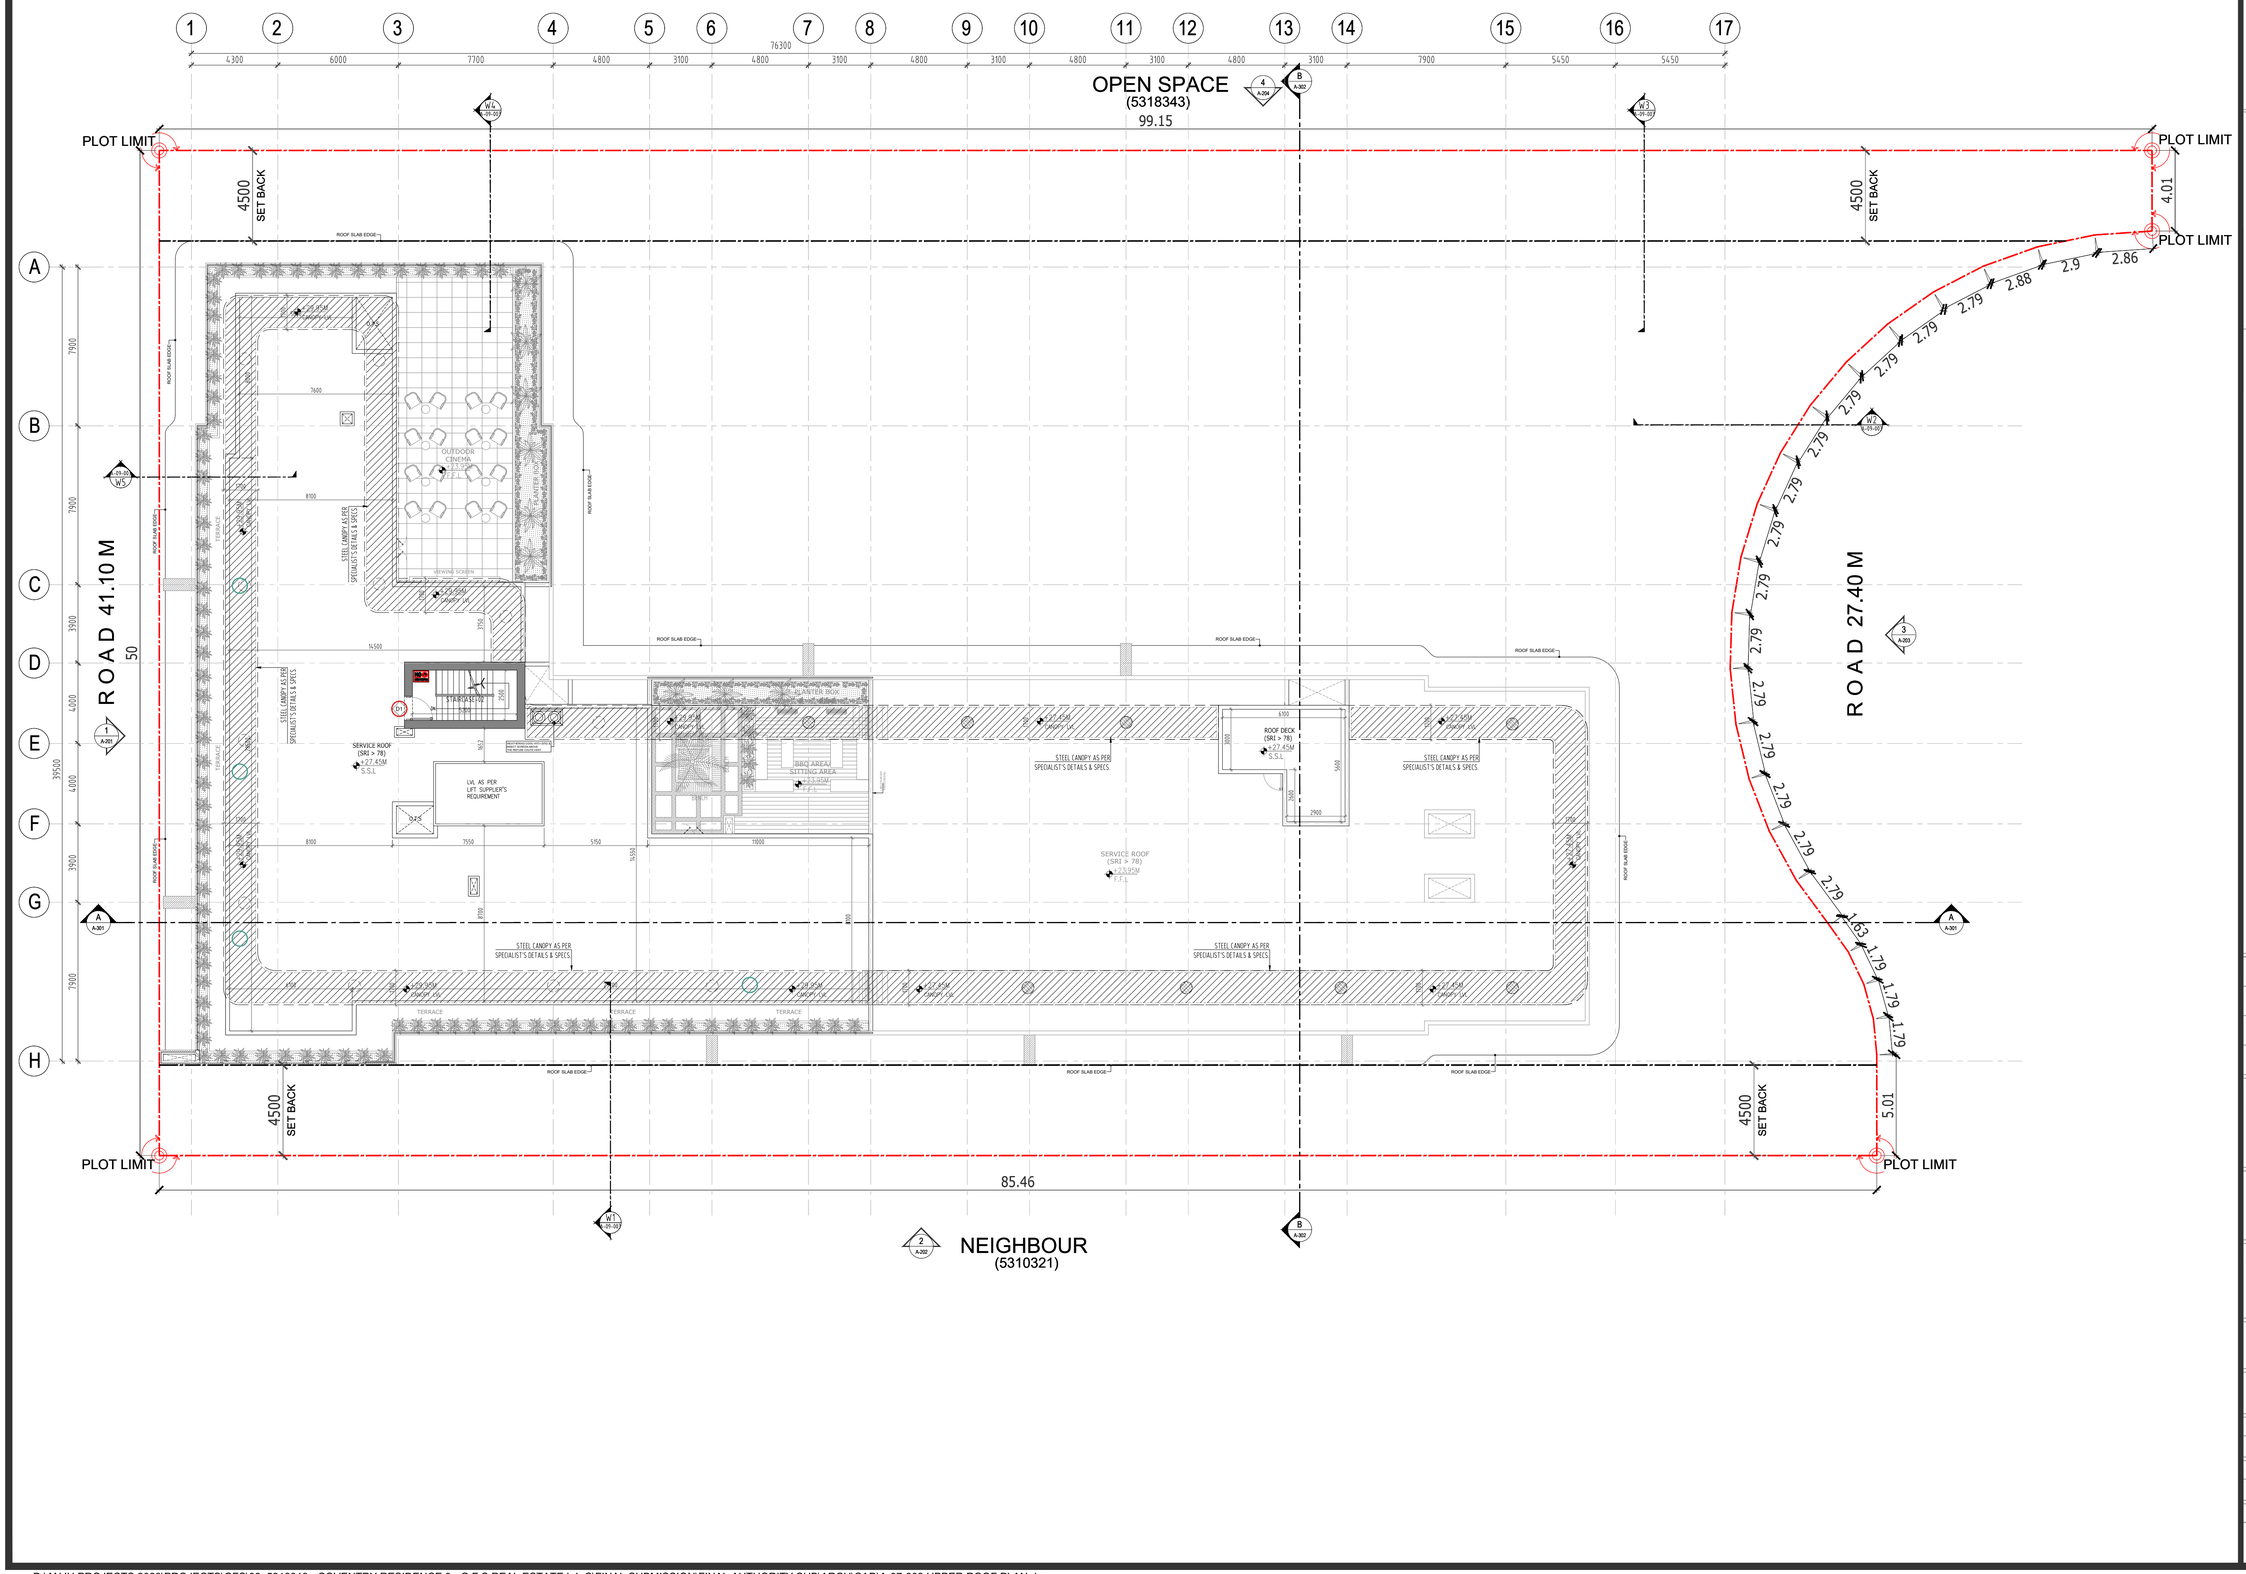

NOTES:

1. THIS DRAWING MAY NOT BE REPRODUCED BY ANY MEANS WITHOUT PRIOR APPROVAL FROM EMSQUARE
2. DRAWINGS ARE NOT TO BE SCALED, STATED DIMENSIONS ONLY ARE TO BE TAKEN.
3. ANY INCONSISTENCY OR DISCRIPANCY IS TO BE BROUGHT TO THE ATTENTION OF & RESOLVED BY THE ARCHITECT/ENGINEER BEFORE THE WORK IS PUT IN HAND.

DATE	DESCRIPTION	BY

CONSULTANT :

EMSQUARE
ENGINEERING CONSULTANTS
ARCHITECTS-CIVIL ENGINEERS-INTERIORS
P.O. Box 181903, Tel: +971 4 2729009, Fax: +971 4 2729334
Email: emsquare@emirates.net.ae

OWNER :

G F S REAL ESTATE L.L.C

JOB TITLE :

PROPOSED RESIDENTIAL BUILDING (B+G+5+ROOF)

PLOT NO. / PARCEL ID	BLOCK / COMMUNITY
5310319	SAIH SHUAIB 2

DRAWING TITLE :

UPPER ROOF PLAN

ARCHITECT :	STRUCTURAL ENGR. :	DRAWN :
SMITHA		SHAFI
SCALE :	DATE :	CHECKED BY :
1:150	JUN-2025	BABU
JOB NO :	DRAWING NO. :	REVISION NO. :
—	A-07-009	..

: D:\ANJU PROJECTS 2023\PROJECTS\GFS\08. 5310319 - COVENTRY RESIDENCE 3 - G F S REAL ESTATE L.L.C\FINAL SUBMISSION\FINAL AUTHORITY SUB\ARCH\CAD\A-07-009 UPPER ROOF PLAN.dwg