A-13-003 SCHEDULE OF WINDOWS-02 - read directly off the drawing (dashed; regions read)

SCHEDULE OF WINDOWS

READ (VISUAL) FROM THIS SCHEDULE
- DW 11: NO. 1 read - plans 1 - CLOSED
- DW 13: NO. 1 read - plans 1 - CLOSED
- DW 14: NO. 1 read - plans 1 - CLOSED
- DW 15: NO. 1 read - plans 1 - CLOSED
- DW 16: NO. 1 read - plans 1 - CLOSED
- DW 17: NO. 1 read - plans 1 - CLOSED
- DW 18: NO. 1 read - plans 1 - CLOSED
- DW 19: NO. 1 read - plans 1 - CLOSED
- LW 01: NO. 1 read - plans 1 - CLOSED
- LW 02: NO. 1 read - plans 1 - CLOSED
- LW 03: NO. 1 read - plans 0 - OPEN


TYPE	PARTLY FIXED PARTLY SLIDING DOOR
SIZE	AS SHOWN
LOCATION	GYMNASIUM (M,F) (LOWER ROOF)
NO.	01

DESCRIPTION:

POWDER COATED ALUMINUM FRAMED DOOR WINDOW (THERMAL BREAK) WITH 6MM REFLECTIVE BELGIUM HEAT STRENGTHENED GLASS+12MM AIR GAP+ 6MM TEMPERED CLEAR GLASS.
GLASS PERFORMANCE (U VALUE& SHADING COEFFICIENT) SHALL BE AS PER GREEN BUILDING REQUIREMENTS.

* SHALL BE PROVIDED WITH WEATHER STRIPS

DW 11

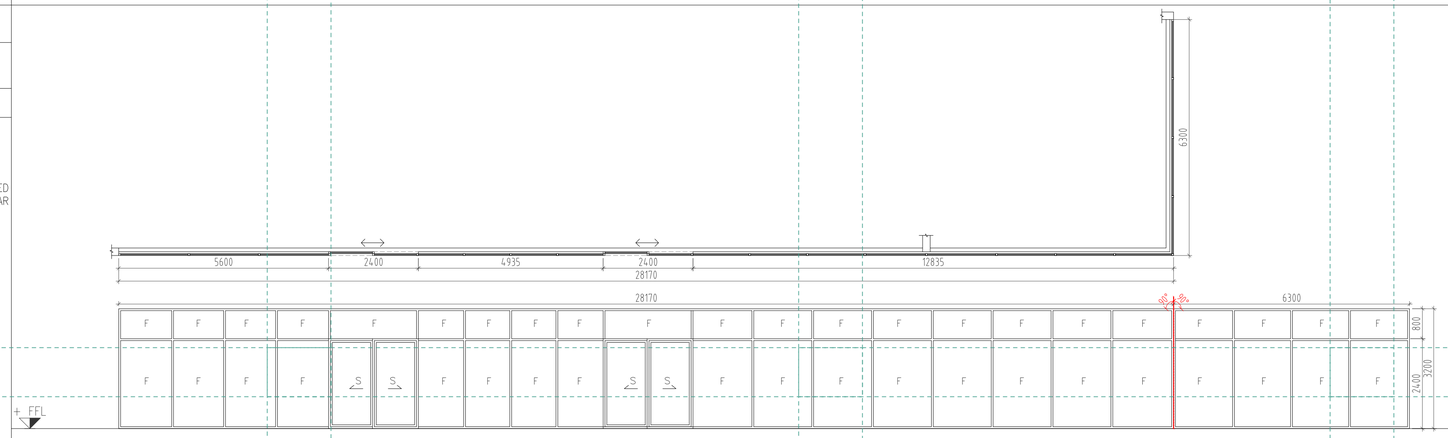


TYPE	PARTLY FIXED PARTLY HINGED DOOR
SIZE	AS SHOWN
LOCATION	GYMNASIUM (F) (LOWER ROOF)
NO.	01

DESCRIPTION:

POWDER COATED ALUMINUM FRAMED DOOR WINDOW (THERMAL BREAK) WITH 6MM REFLECTIVE BELGIUM HEAT STRENGTHENED GLASS+12MM AIR GAP+ 6MM TEMPERED CLEAR GLASS.
GLASS PERFORMANCE (U VALUE& SHADING COEFFICIENT) SHALL BE AS PER GREEN BUILDING REQUIREMENTS.

* SHALL BE PROVIDED WITH WEATHER STRIPS

DW 13

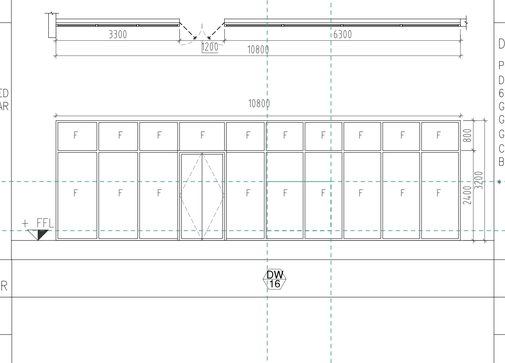


TYPE	PARTLY FIXED PARTLY HINGED DOOR
SIZE	AS SHOWN
LOCATION	GYMNASIUM (M) (LOWER ROOF)
NO.	01

DESCRIPTION:

POWDER COATED ALUMINUM FRAMED DOOR WINDOW (THERMAL BREAK) WITH 6MM REFLECTIVE BELGIUM HEAT STRENGTHENED GLASS+12MM AIR GAP+ 6MM TEMPERED CLEAR GLASS.
GLASS PERFORMANCE (U VALUE& SHADING COEFFICIENT) SHALL BE AS PER GREEN BUILDING REQUIREMENTS.

* SHALL BE PROVIDED WITH WEATHER STRIPS

DW 14

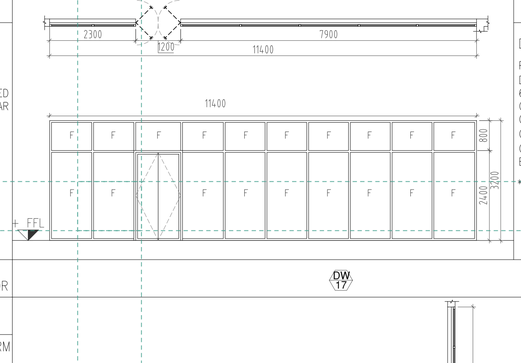


TYPE	PARTLY FIXED PARTLY HINGED DOOR
SIZE	AS SHOWN
LOCATION	CORRIDOR (LOWER ROOF)
NO.	01

DESCRIPTION:

POWDER COATED ALUMINUM FRAMED DOOR WINDOW (THERMAL BREAK) WITH 6MM REFLECTIVE BELGIUM HEAT STRENGTHENED GLASS+12MM AIR GAP+ 6MM TEMPERED CLEAR GLASS.
GLASS PERFORMANCE (U VALUE& SHADING COEFFICIENT) SHALL BE AS PER GREEN BUILDING REQUIREMENTS.

* SHALL BE PROVIDED WITH WEATHER STRIPS

DW 15

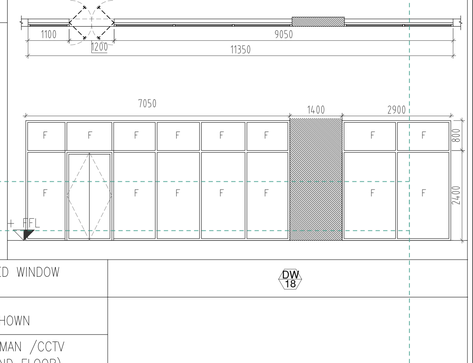


TYPE	PARTLY FIXED PARTLY HINGED DOOR
SIZE	AS SHOWN
LOCATION	CORRIDOR (LOWER ROOF)
NO.	01

DESCRIPTION:

POWDER COATED ALUMINUM FRAMED DOOR WINDOW (THERMAL BREAK) WITH 6MM REFLECTIVE BELGIUM HEAT STRENGTHENED GLASS+12MM AIR GAP+ 6MM TEMPERED CLEAR GLASS.
GLASS PERFORMANCE (U VALUE& SHADING COEFFICIENT) SHALL BE AS PER GREEN BUILDING REQUIREMENTS.

* SHALL BE PROVIDED WITH WEATHER STRIPS

DW 16

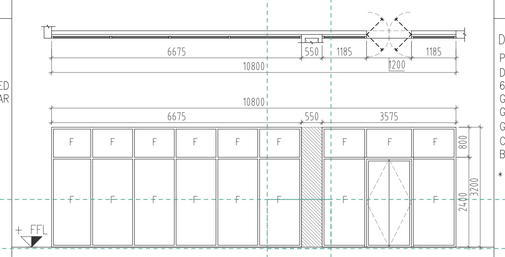


TYPE	PARTLY FIXED PARTLY HINGED DOOR
SIZE	AS SHOWN
LOCATION	DINING / LIVING,BEDRM (1ST FLOOR)
NO.	01

DESCRIPTION:

POWDER COATED ALUMINUM FRAMED DOOR WINDOW (THERMAL BREAK) WITH 6MM REFLECTIVE BELGIUM HEAT STRENGTHENED GLASS+12MM AIR GAP+ 6MM TEMPERED CLEAR GLASS.
GLASS PERFORMANCE (U VALUE& SHADING COEFFICIENT) SHALL BE AS PER GREEN BUILDING REQUIREMENTS.

* SHALL BE PROVIDED WITH WEATHER STRIPS

DW 17

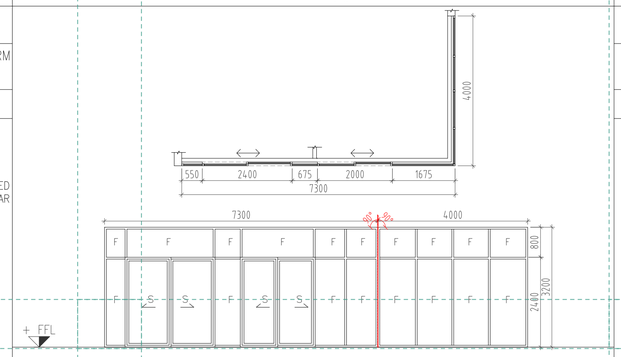


TYPE	HINGED WINDOW
SIZE	AS SHOWN
LOCATION	WATCHMAN /CCTV (GROUND FLOOR)
NO.	01

POWDER COATED ALUMINUM FRAMED DOOR WINDOW (THERMAL BREAK) WITH 6MM REFLECTIVE BELGIUM HEAT STRENGTHENED GLASS+12MM AIR GAP+ 6MM TEMPERED CLEAR GLASS.
GLASS PERFORMANCE (U VALUE& SHADING COEFFICIENT) SHALL BE AS PER GREEN BUILDING REQUIREMENTS.

* SHALL BE PROVIDED WITH WEATHER STRIPS

DW 18

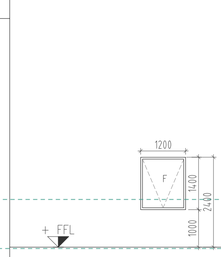


TYPE	SLIDING DOOR
SIZE	AS SHOWN
LOCATION	REAR ENT.LIFT LOBBY (GROUND FLOOR)
NO.	01

DESCRIPTION:

POWDER COATED ALUMINUM FRAMED DOOR WINDOW (THERMAL BREAK) WITH 6MM REFLECTIVE BELGIUM HEAT STRENGTHENED GLASS+12MM AIR GAP+ 6MM TEMPERED CLEAR GLASS.
GLASS PERFORMANCE (U VALUE& SHADING COEFFICIENT) SHALL BE AS PER GREEN BUILDING REQUIREMENTS.

* SHALL BE PROVIDED WITH WEATHER STRIPS

DW 19

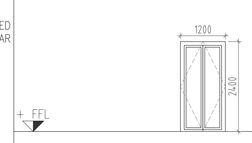


TYPE	FIXED
SIZE	AS SHOWN
LOCATION	SUBSTATION (GROUND FLR.)
NO.	01

DESCRIPTION:

POWDER COATED ALUMINUM LOUVRE WINDOW AS PER CONSULTANT AND OWNER'S APPROVAL

LW 01

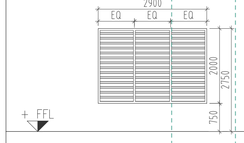


TYPE	FIXED
SIZE	AS SHOWN
LOCATION	POOL PUMP (GROUND FLR.)
NO.	01

DESCRIPTION:

POWDER COATED ALUMINUM LOUVRE WINDOW AS PER CONSULTANT AND OWNER'S APPROVAL

LW 02

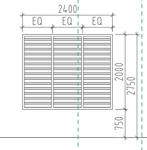


TYPE	FIXED
SIZE	AS SHOWN
LOCATION	GENER.ROOM (BASEMENT FLR.)
NO.	01

DESCRIPTION:

POWDER COATED ALUMINUM LOUVRE WINDOW AS PER CONSULTANT AND OWNER'S APPROVAL

LW 03

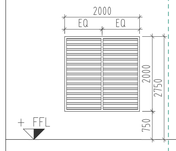

NOTE.: ALL TIMBER/WOOD TO BE CERTIFIED / ACCREDITED TIMBER AS PER CLAUSE 701.02/701.06/701.07/701.08/404.01 GBR SP-2

PROVIDE EXTERNAL THRESHOLD FOR TERRACES

*U VALUE = 1.7 w/m2K
ALL APPARTMENT BALCONY DOORS WINDOWS AND MAIN DOORS LEADING TO CORRIDORS HAS TO BE WETHER STRIPPED.

*SHADING COEFFICIENT = 0.20
* COLOUR & DESIGN AS PER CONSULTANTS APPROVAL

NOTES:

1. THIS DRAWING MAY NOT BE REPRODUCED BY ANY MEANS WITHOUT PRIOR APPROVAL FROM EMSQUARE
2. DRAWINGS ARE NOT TO BE SCALED, STATED DIMENSIONS ONLY ARE TO BE TAKEN.
3. ANY INCONSISTENCY OR DISCRIPANCY IS TO BE BROUGHT TO THE ATTENTION OF & RESOLVED BY THE ARCHITECT/ENGINEER BEFORE THE WORK IS PUT IN HAND.

DATE	DESCRIPTION	BY

CONSULTANT :

EMSQUARE
ENGINEERING CONSULTANTS
ARCHITECTS-CIVIL ENGINEERS-INTERIORS
P.O. Box 181903, Tel: +971 4 2729009, Fax: +971 4 2729334
Email: emsquare@emirates.net.ae

OWNER :

G F S REAL ESTATE L.L.C

JOB TITLE :

PROPOSED RESIDENTIAL BUILDING (B+G+5+ROOF)

PLOT NO. / PARCEL ID	BLOCK / COMMUNITY
5310319	SAIH SHUAIB 2

DRAWING TITLE :

SCHEDULE OF WINDOWS-02

ARCHITECT :	STRUCTURAL ENGR. :	DRAWN :
SMITHA		SHAFI
SCALE :	DATE :	CHECKED BY :
1:125	JUN-2025	BABU
JOB NO :	DRAWING NO. :	REVISION NO. :
—	A-13-003	..

: D:\ANJU PROJECTS 2023\PROJECTS\GFS\08. 5310319 - COVENTRY RESIDENCE 3 - G F S REAL ESTATE L.L.C\FINAL SUBMISSION\FINAL AUTHORITY SUB\ARCH\CAD\A-13-002 SCHEDULE OF WINDOWS.dwg